



US 1 IS CONSIDERED TO RUN
IN A NORTH-SOUTH DIRECTION


EXISTING SIGNS

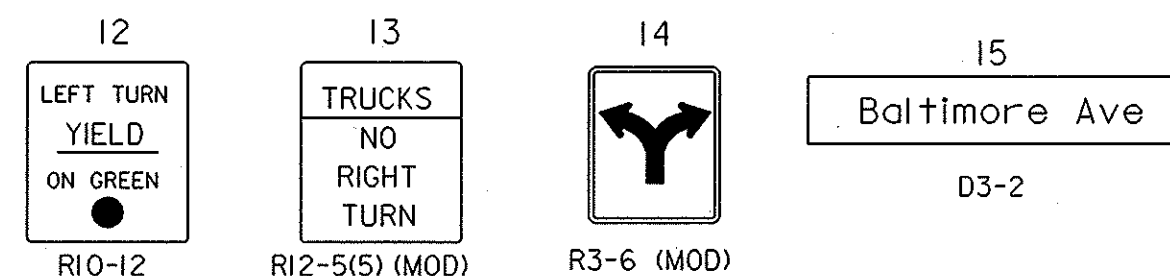

PROPOSED SIGNALS

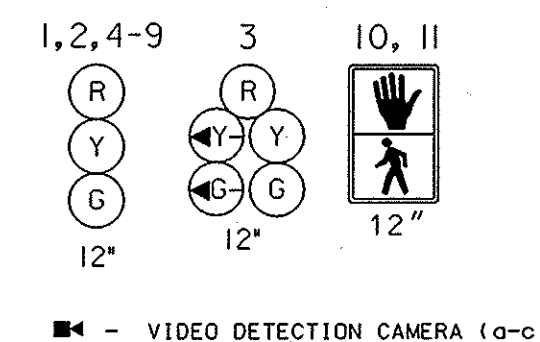


NEMA PHASING

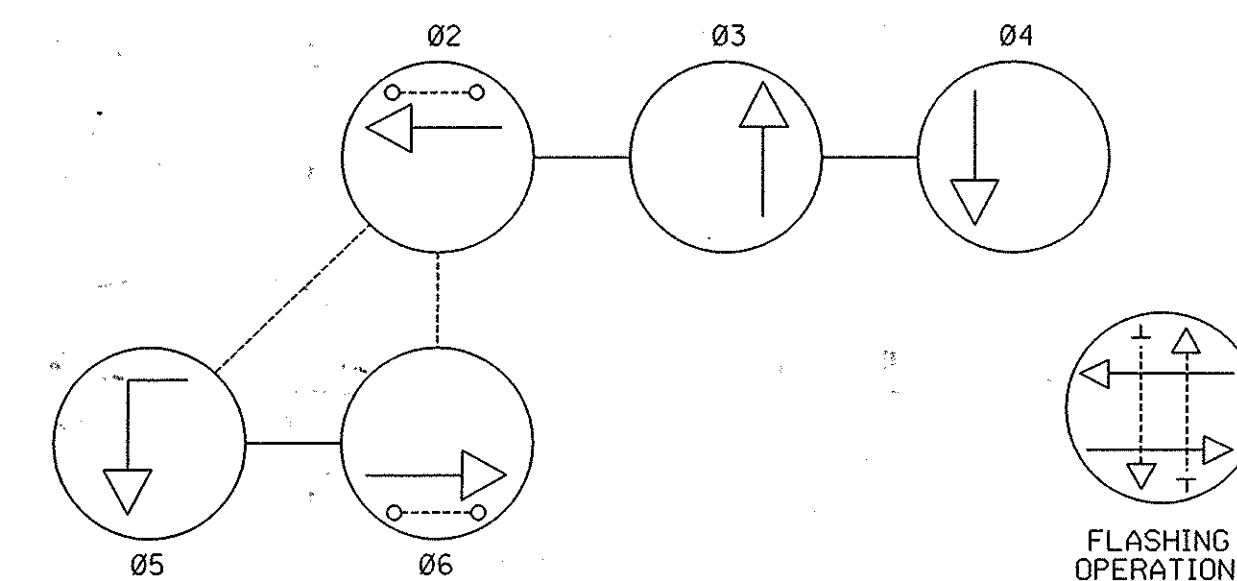

PHASING NOTES:
1. PHASES ASSOCIATED BY A DASHED LINE WILL OPERATE CONCURRENTLY
2. PHASES ASSOCIATED BY A SOLID LINE WILL NOT OPERATE CONCURRENTLY


EXISTING UNDERGROUND I/C
SOUTH TO GALLATIN STREET

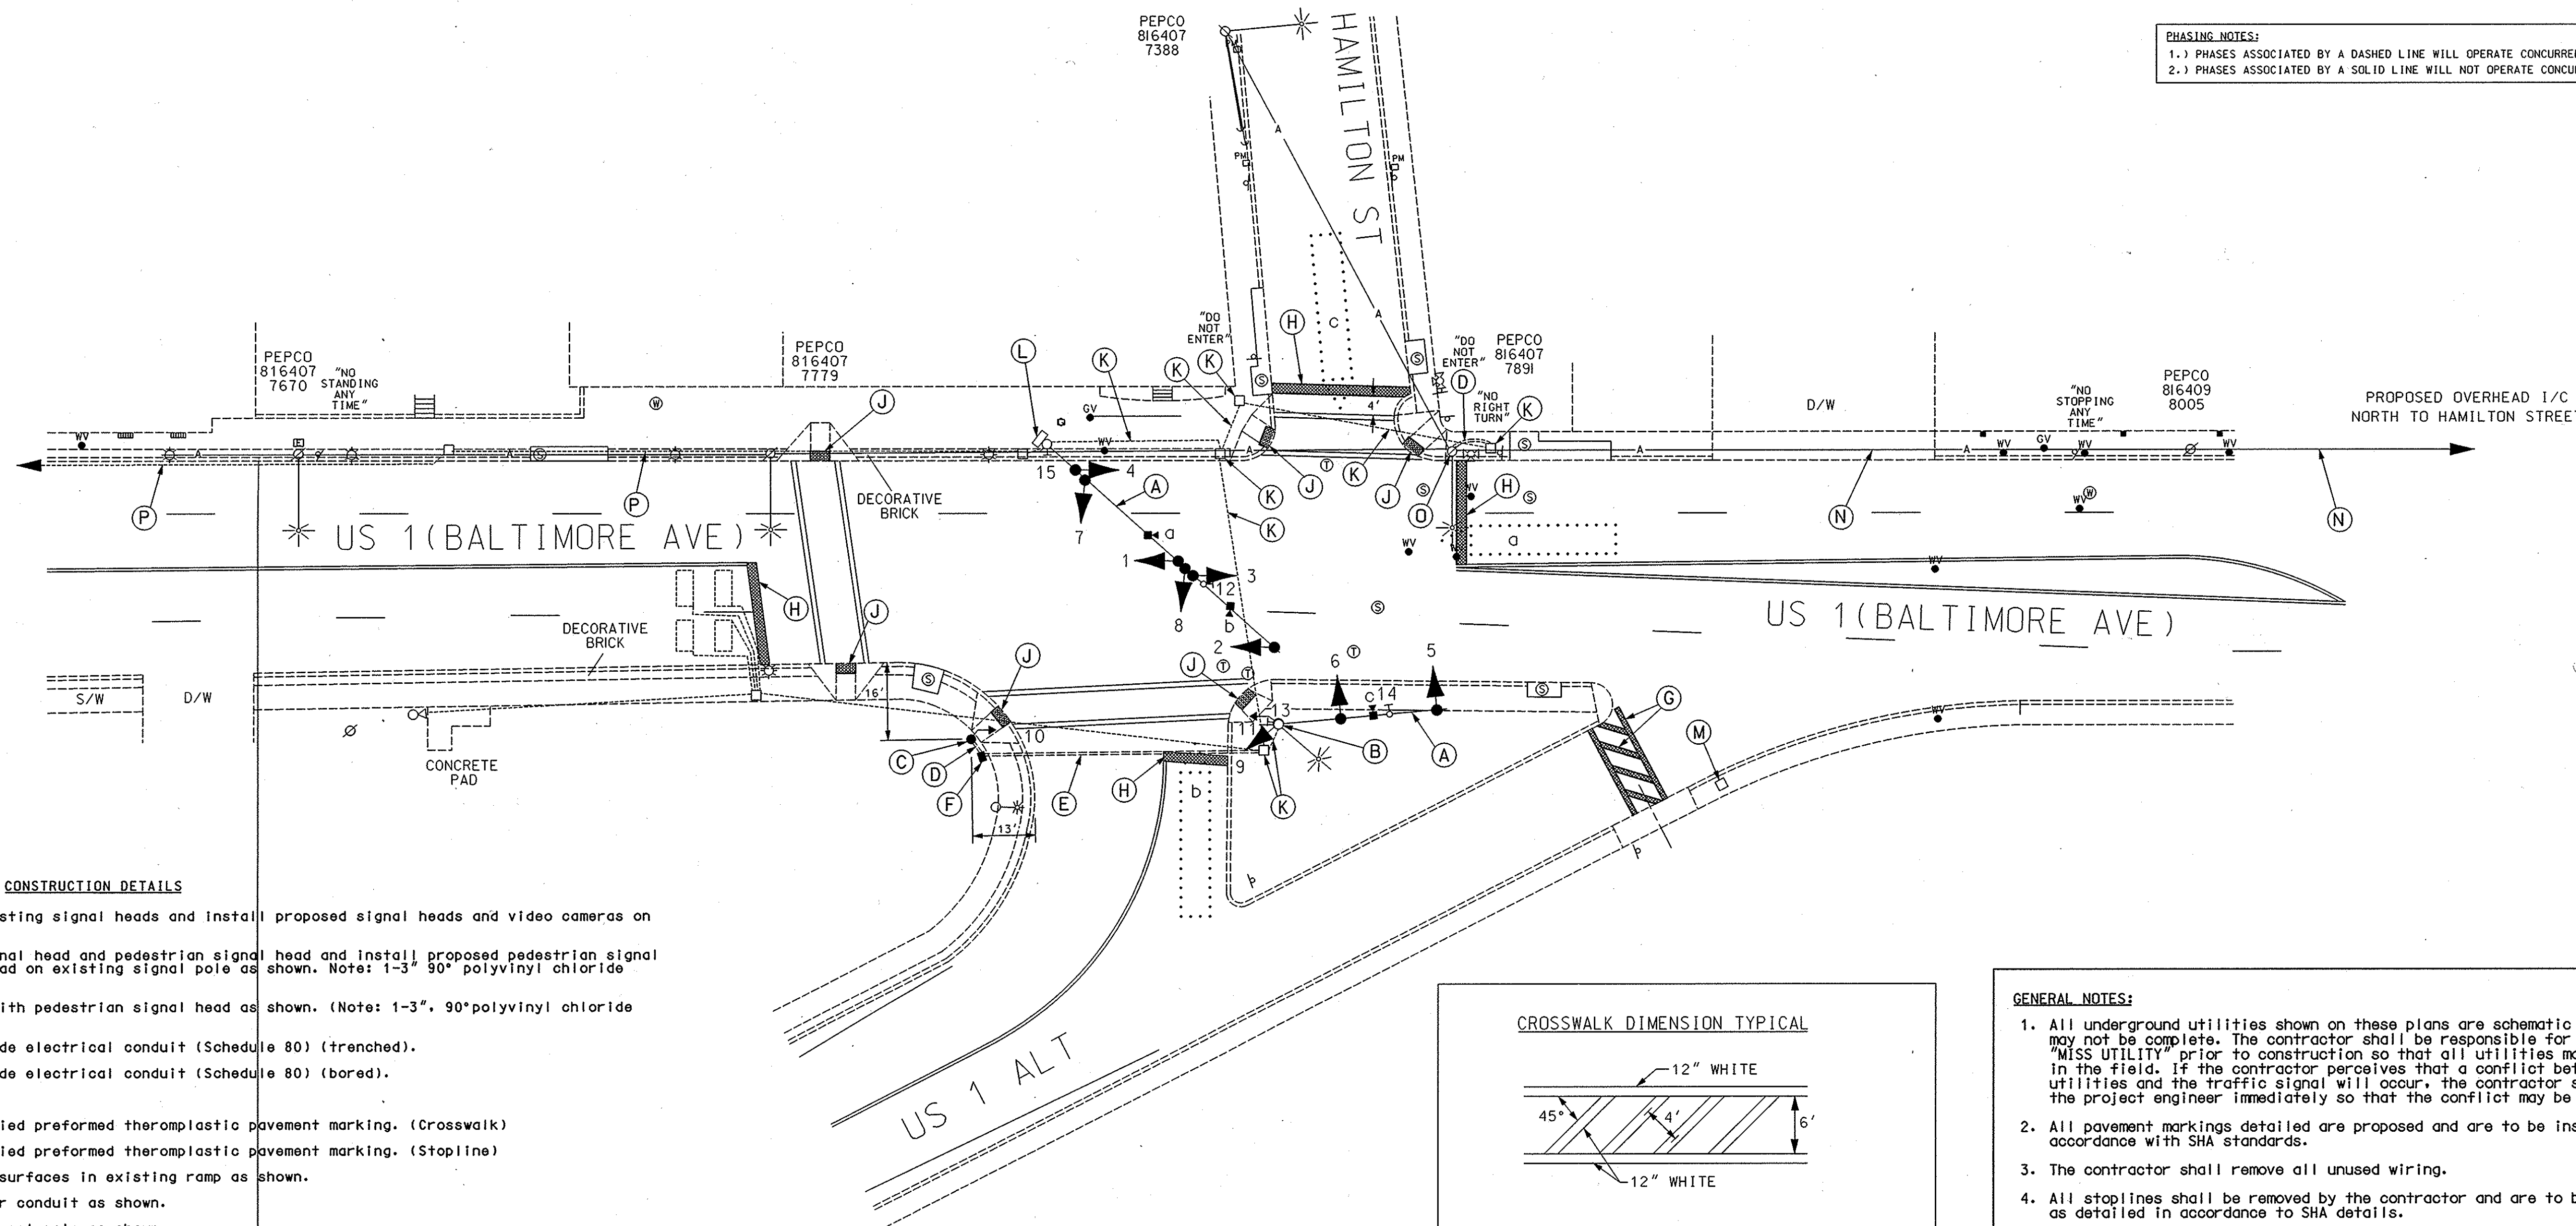

CONSTRUCTION DETAILS

- Contractor shall remove existing signal heads and install proposed signal heads and video cameras on existing mast arm as shown.
- Remove existing traffic signal head and pedestrian signal head and install proposed pedestrian signal head and proposed signal head on existing signal pole as shown. Note: 1-3" 90° polyvinyl chloride (Schedule 80) bend.
- Install 10' pedestal pole with pedestrian signal head as shown. (Note: 1-3" 90° polyvinyl chloride (Schedule 80) bend.)
- Install 3" polyvinyl chloride electrical conduit (Schedule 80) (trenched).
- Install 4" polyvinyl chloride electrical conduit (Schedule 80) (bored).
- Install handhole.
- Install 12" white heat applied preformed thermoplastic pavement marking. (Crosswalk)
- Install 24" white heat applied preformed thermoplastic pavement marking. (Stopline)
- Install detectable warning surfaces in existing ramp as shown.
- Use existing handhole and/or conduit as shown.
- Use existing cabinet and signal pole as shown.
- Remove existing handhole, cap and abandon all existing conduit runs associated with this handhole.
- Proposed Interconnect see Interconnect plans for more details.
- The contractor shall install 3" galvanized riser on existing wood pole.
- Maintain existing underground interconnect.

CROSSWALK DIMENSION TYPICAL

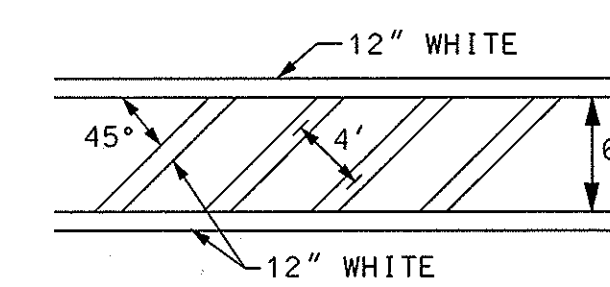

SCALE: 1" = 10'

GENERAL NOTES:

- All underground utilities shown on these plans are schematic only and may not be complete. The contractor shall be responsible for notifying "MISS UTILITY" prior to construction so that all utilities may be located in the field. If the contractor perceives that a conflict between the utilities and the traffic signal will occur, the contractor shall notify the project engineer immediately so that the conflict may be resolved.
- All pavement markings detailed are proposed and are to be installed in accordance with SHA standards.
- The contractor shall remove all unused wiring.
- All stoplines shall be removed by the contractor and are to be replaced as detailed in accordance to SHA details.

GEOMETRIC LEGEND	
PROPOSED	---
EXISTING	----
LEGEND OF UNDERGROUND AND OVERHEAD UTILITIES	
AERIAL CABLE	—A—A—
ELECTRIC	—E—E—
TELEPHONE	—T—T—
GAS	—G—G—
SEWER	—S—S—
WATER	—W—W—
CABLE TV	—TV—TV—



REVISIONS		APPROVALS	
2-15-05	TRAFFIC SIGNAL RECONSTRUCTION AND SYSTEMIZATION	TEAM LEADER, TRAFFIC ENGINEERING DESIGN DIVISION	
RR2	3-27-00	ASST. CHIEF, TRAFFIC ENGINEERING DESIGN DIVISION	
RR2	ASBUILT FOR RED LIGHT CAMERA	CHIEF, TRAFFIC ENGINEERING DESIGN DIVISION	
A	(DATE UNKNOWN) MODIFY EXISTING SIGNAL	DIRECTOR, TRAFFIC & SAFETY	

MARYLAND DOT - STATE HIGHWAY ADMINISTRATION Office of Traffic & Safety TRAFFIC ENGINEERING DESIGN DIVISION			
US 1 AND HAMILTON STREET / US 1 ALT			
DRAWN BY: R. BRITTON	F.A.P. NO. 1127 C	TS NO. 1127 C	SHEET NO. 1 OF 2
CHECKED BY: 1" = 20'	S.H.A. NO. PRINCE GEORGE'S	T.I.M.S. NO. G633	
DATE: 12/10/74	LOG MILE: 16000101.88		